


PLAZA 290

SUITE 460

4,002 SF - AS BUILT

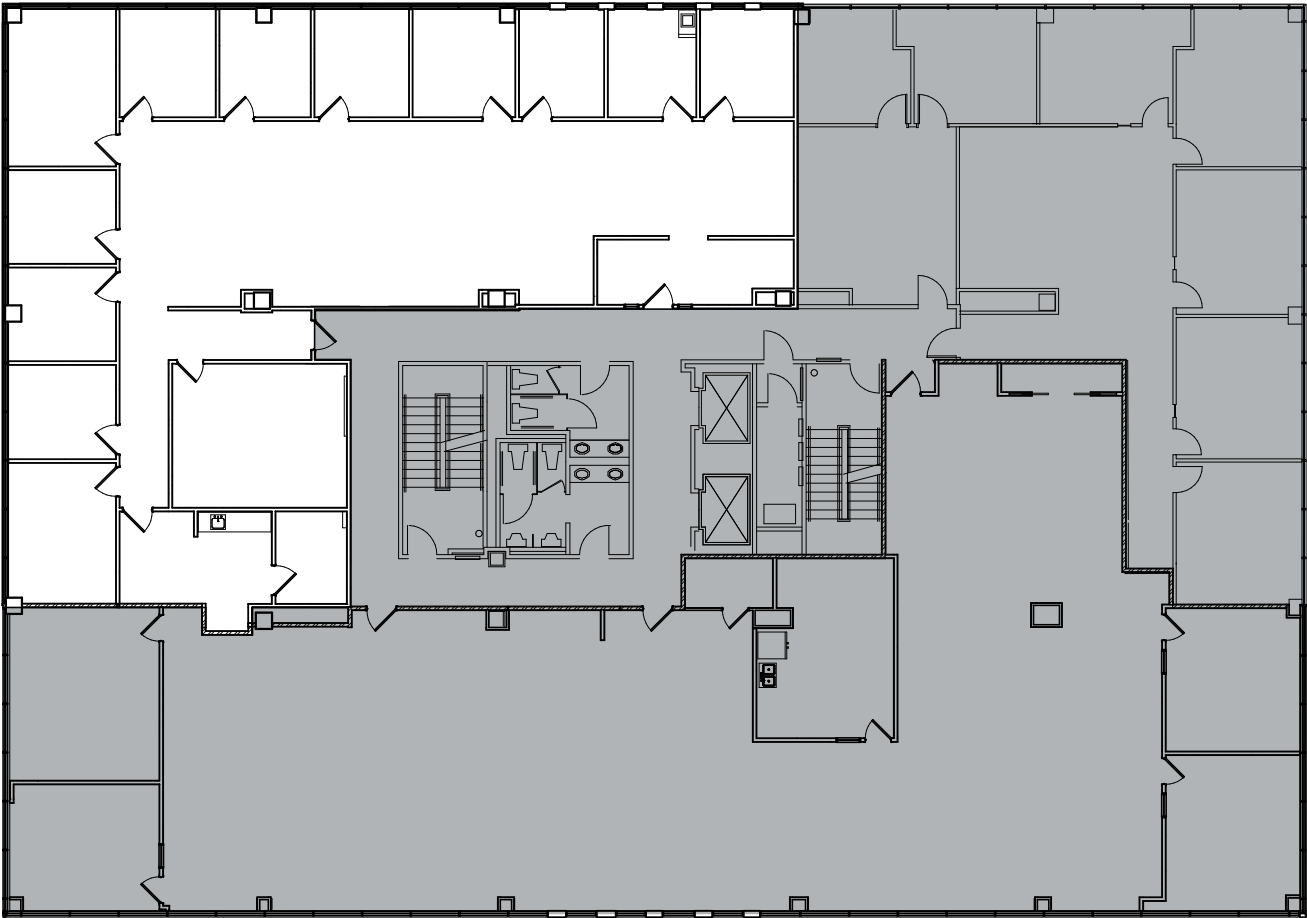

[Click for 360 Virtual Tour](#)