


9500 PARMER, BLDG. 1

SPEC SUITE 150





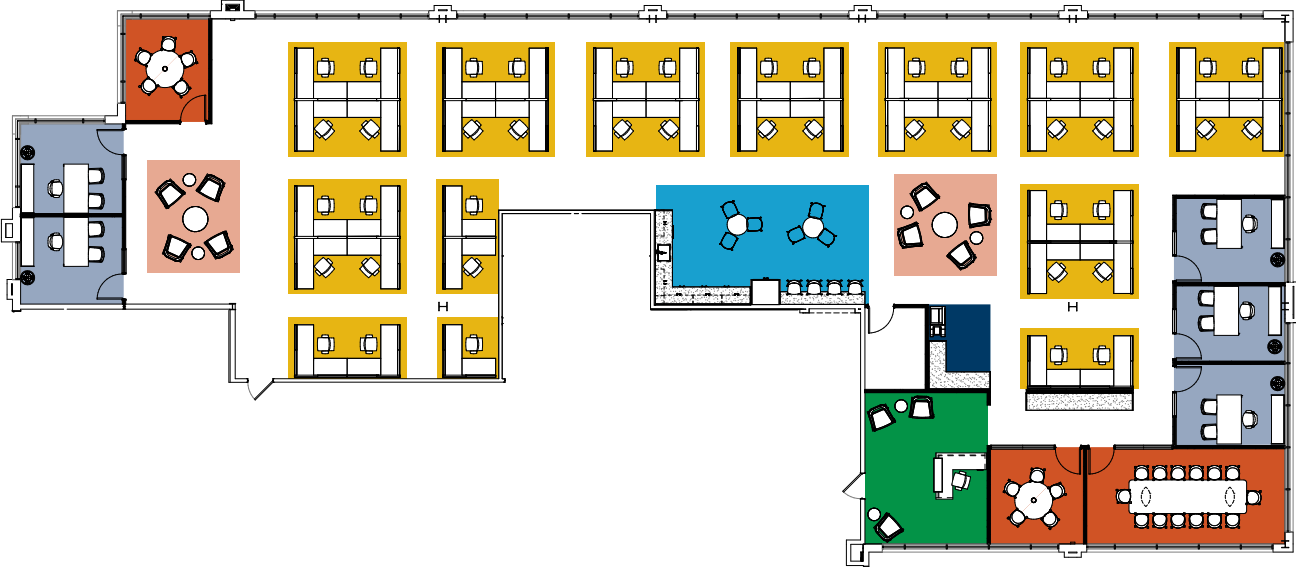


CONCEPTUAL PLAN – 7,679 SF



*Conceptual Furniture Plan



Room Legend

- | | | | |
|--|---|--|---|
|  Break Area |  Copy/Print |  Open Seating |  Reception |
|  Conference |  Open Office |  Private Office | |

9500 PARMER, BLDG. 1
SPEC SUITE 150

CURRENT AS-BUILT PLAN – 7,679 SF

